



Historical Affairs and Landmark Review Board

Arlington County, Virginia

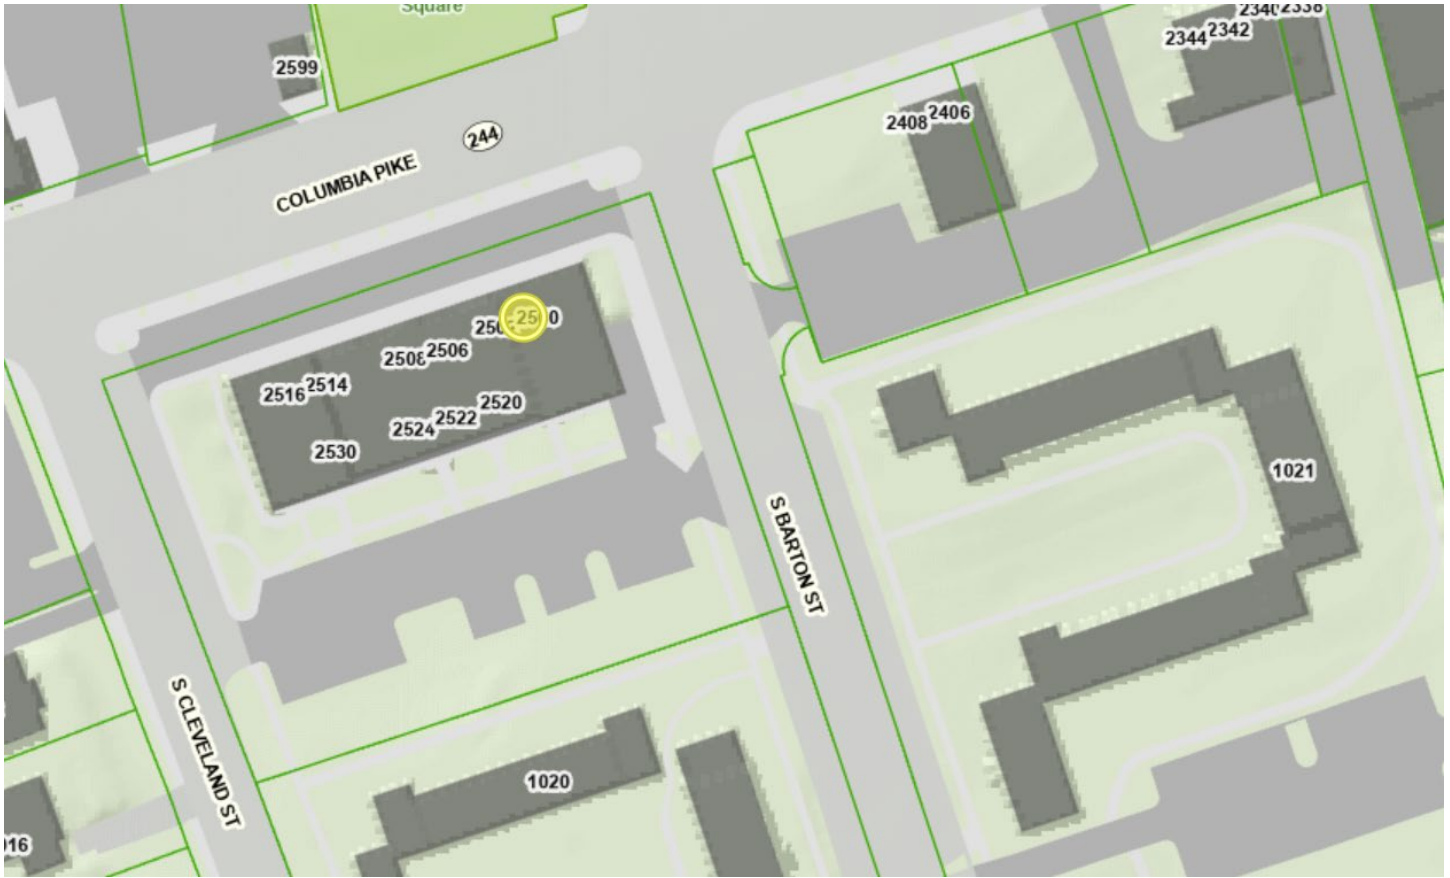


HALRB Meeting January 17, 2024, CoA 24-02

2500 Columbia Pike: Request to install new rear signage.

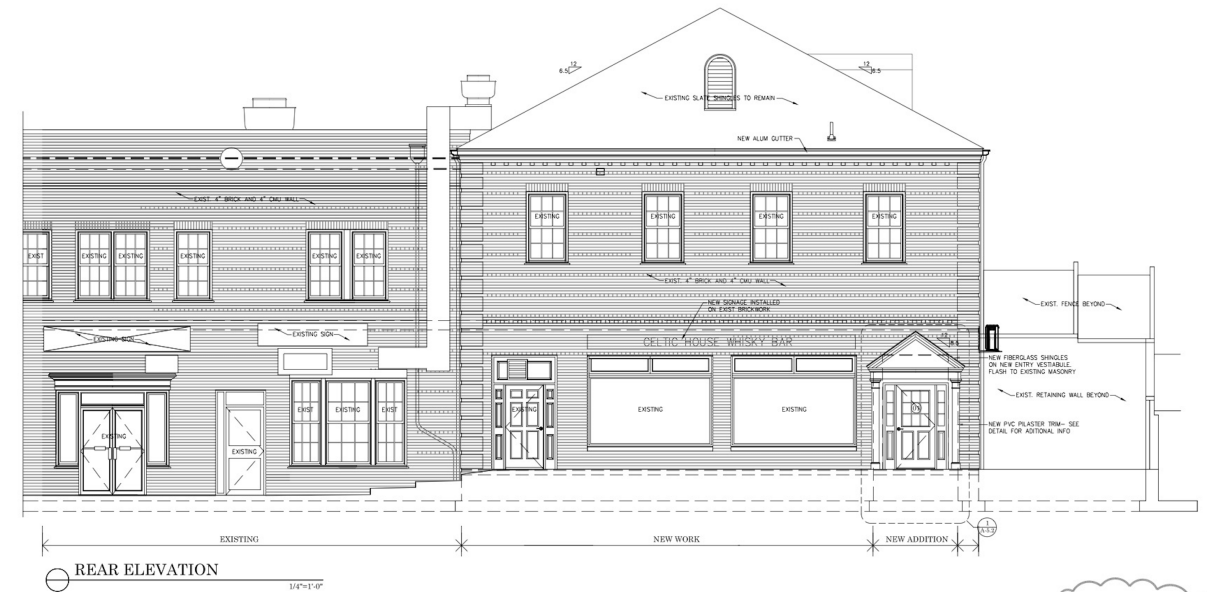


REAR ELEVATION
1/4"=1'-0"

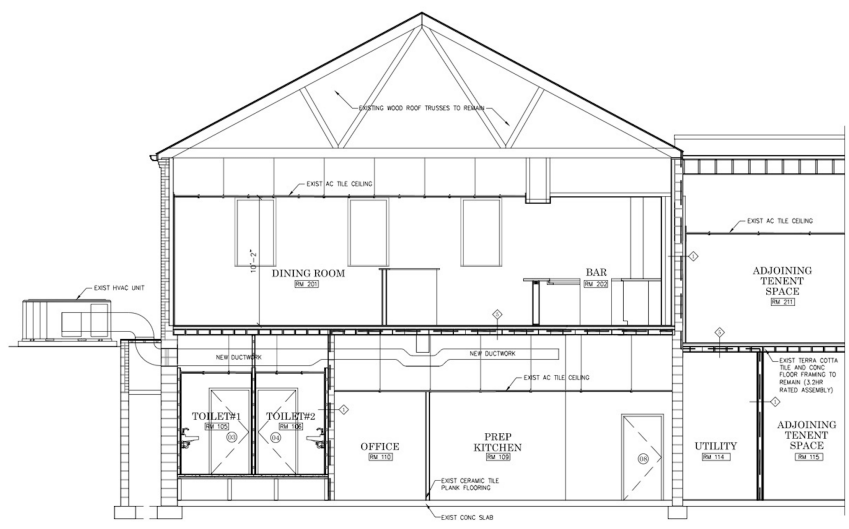

BUILDING SECTION A-A'
1/4"=1'-0"

--- RATED PARTITION

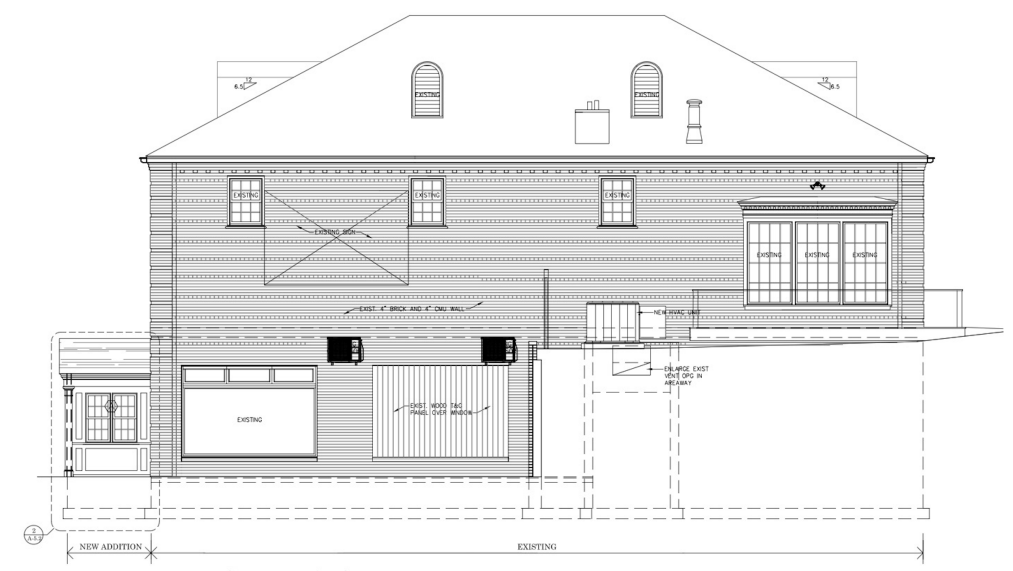

LEFT SIDE ELEVATION
1/4"=1'-0"

SHEET FIRE RATED
PARTITION/FLOOR AND
CEILING REVISED



KJD ARCHITECTS
ARLINGTON, VIRGINIA
4981 AURORA DRIVE KENNINGTON, MARYLAND 20885
(W) 301-583-1511 KJDARCH@AOL.COM
KEVIN J. DRISCOLL, A.L.A.

Irish Pub - Restaurant
& Whiskey Bar
2500 Columbia Pike
Arlington, VA 22204
celtic house

PROJ. No.:
2022-35
REVISIONS:
08-28-23

DRAWING:
REAR ELEVATION
SIDE ELEVATION
BUILDING SECTION A-A'

DATE:
08-10-22
SCALE:
AS NOTED

A-2.1

This Sketch Is The Property Of BRANDVIZION. Any Unauthorized Use Is Prohibited.


Images shown are for reference only and may be screen captures of the actual files as displayed in their native programs, raster images of the file or reduced versions and do not represent the actual file printing resolution.

Design: _____ Production: _____ Quality Control: _____
Revisions: _____

P.O #: _____
Date: 111523
Sales: John McManus
Artist: Karolyn Chaillet

ILLUMINATED BUILDING MOUNTED LIGHT BOX

(1) 24"x240"x6" Aluminum sign cabinet with black returns and printed polycarbonate sign face
Mounted to brick with lag bolts and anchors

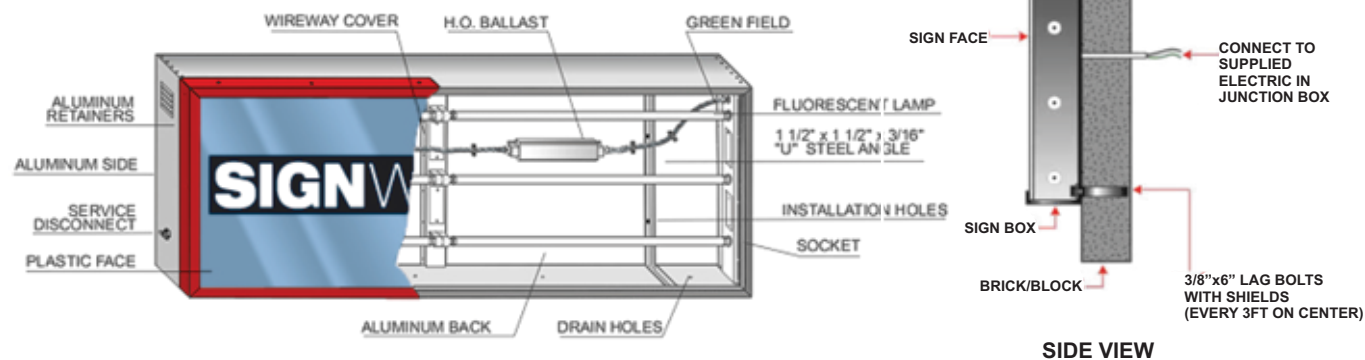


APPROVED
proceed with production
no further proof required

NOT APPROVED
CHANGES AS NOTED
NEW PROOF REQUIRED


Approved By: _____ Date: _____

RUSH INSTALL DELIVERY SHIPPING PICK-UP

Install/Delivery Address: _____

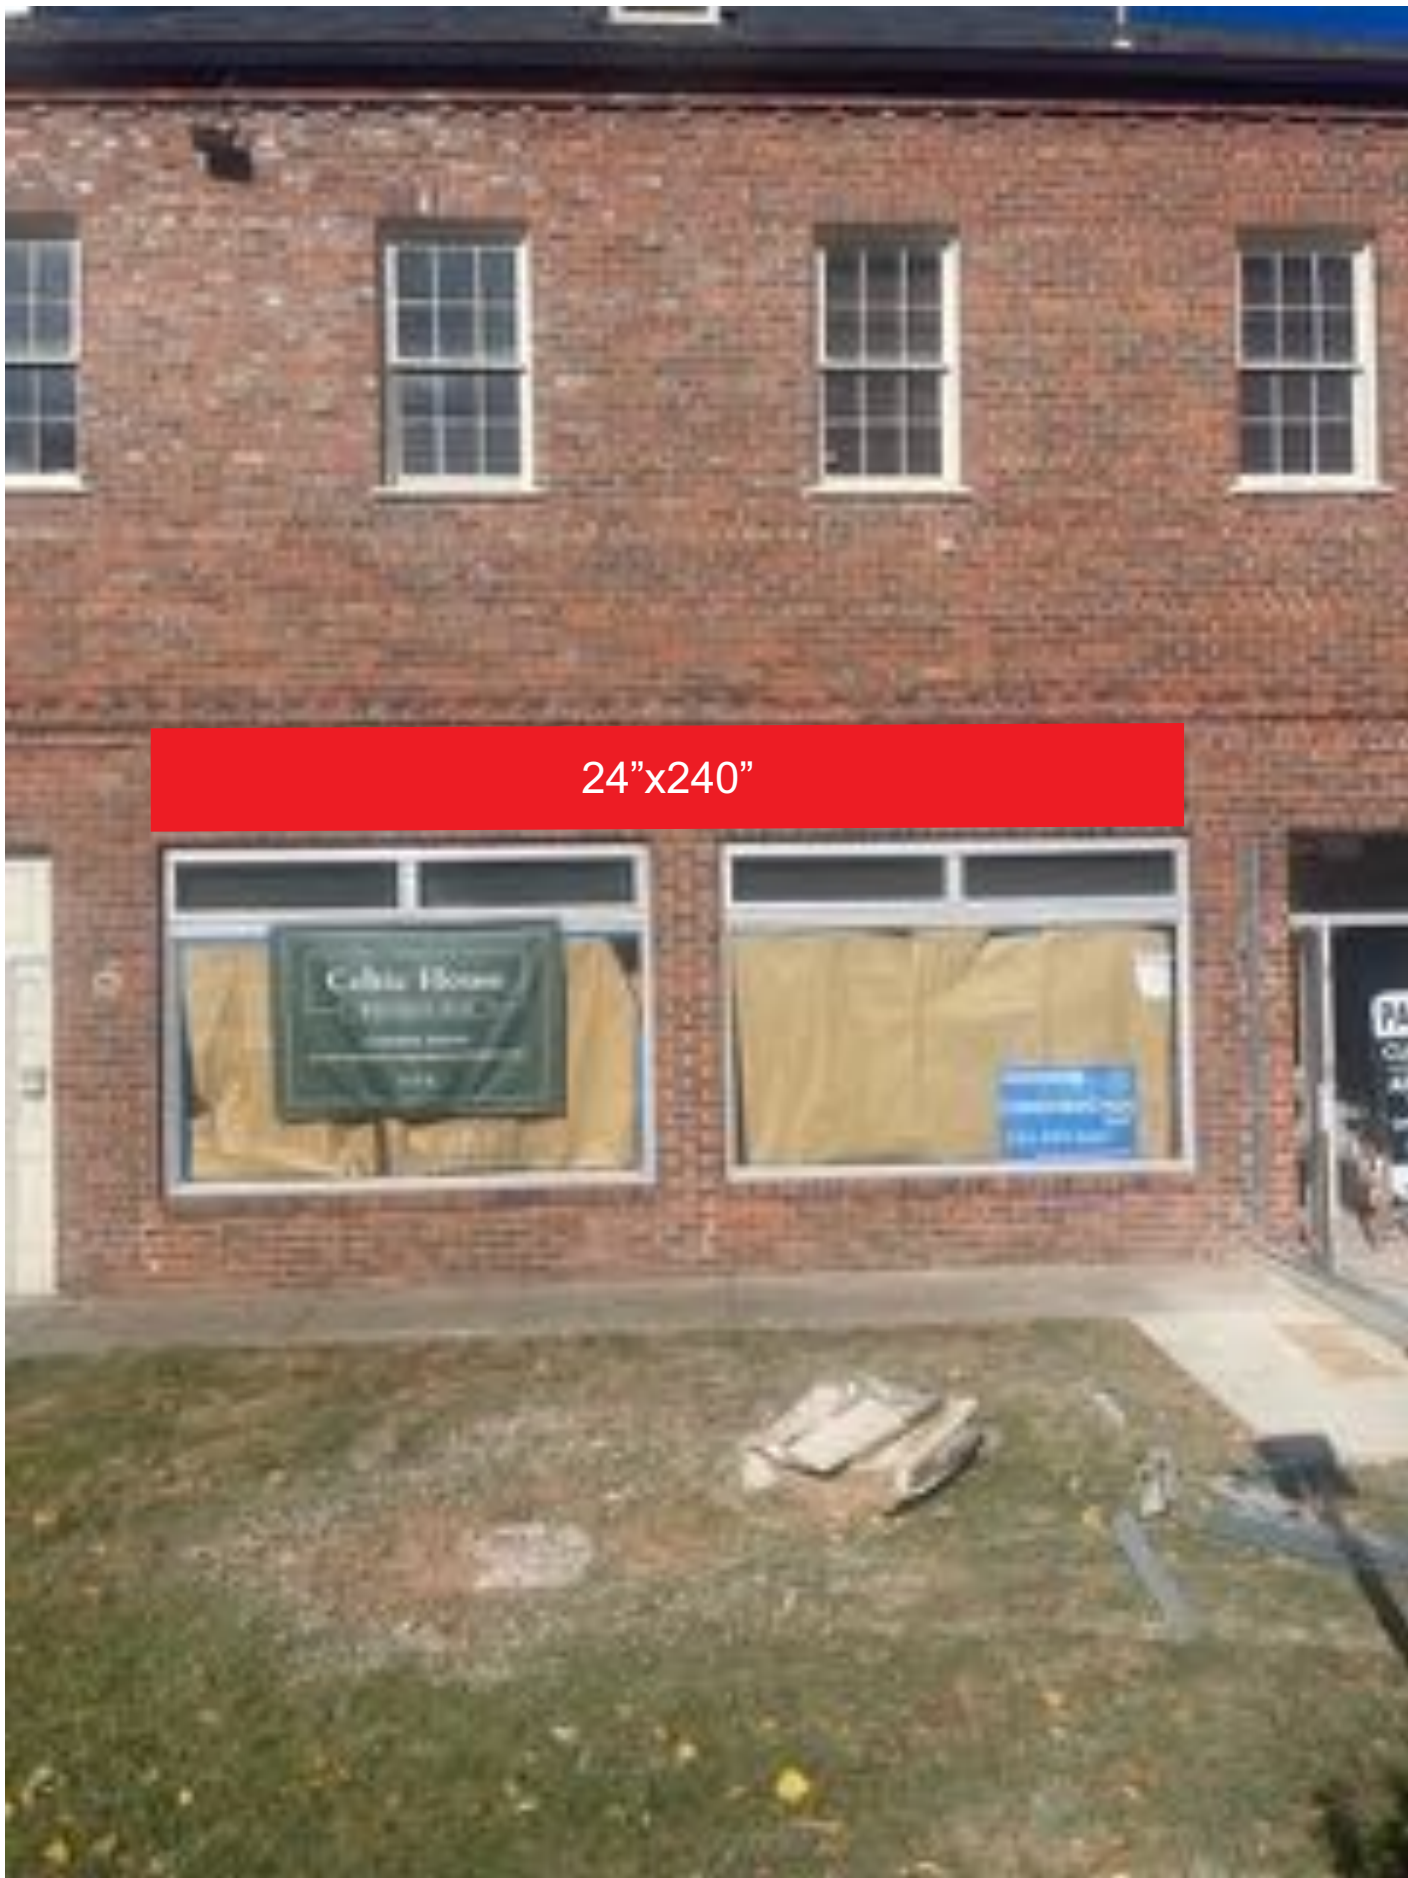

24"x240"

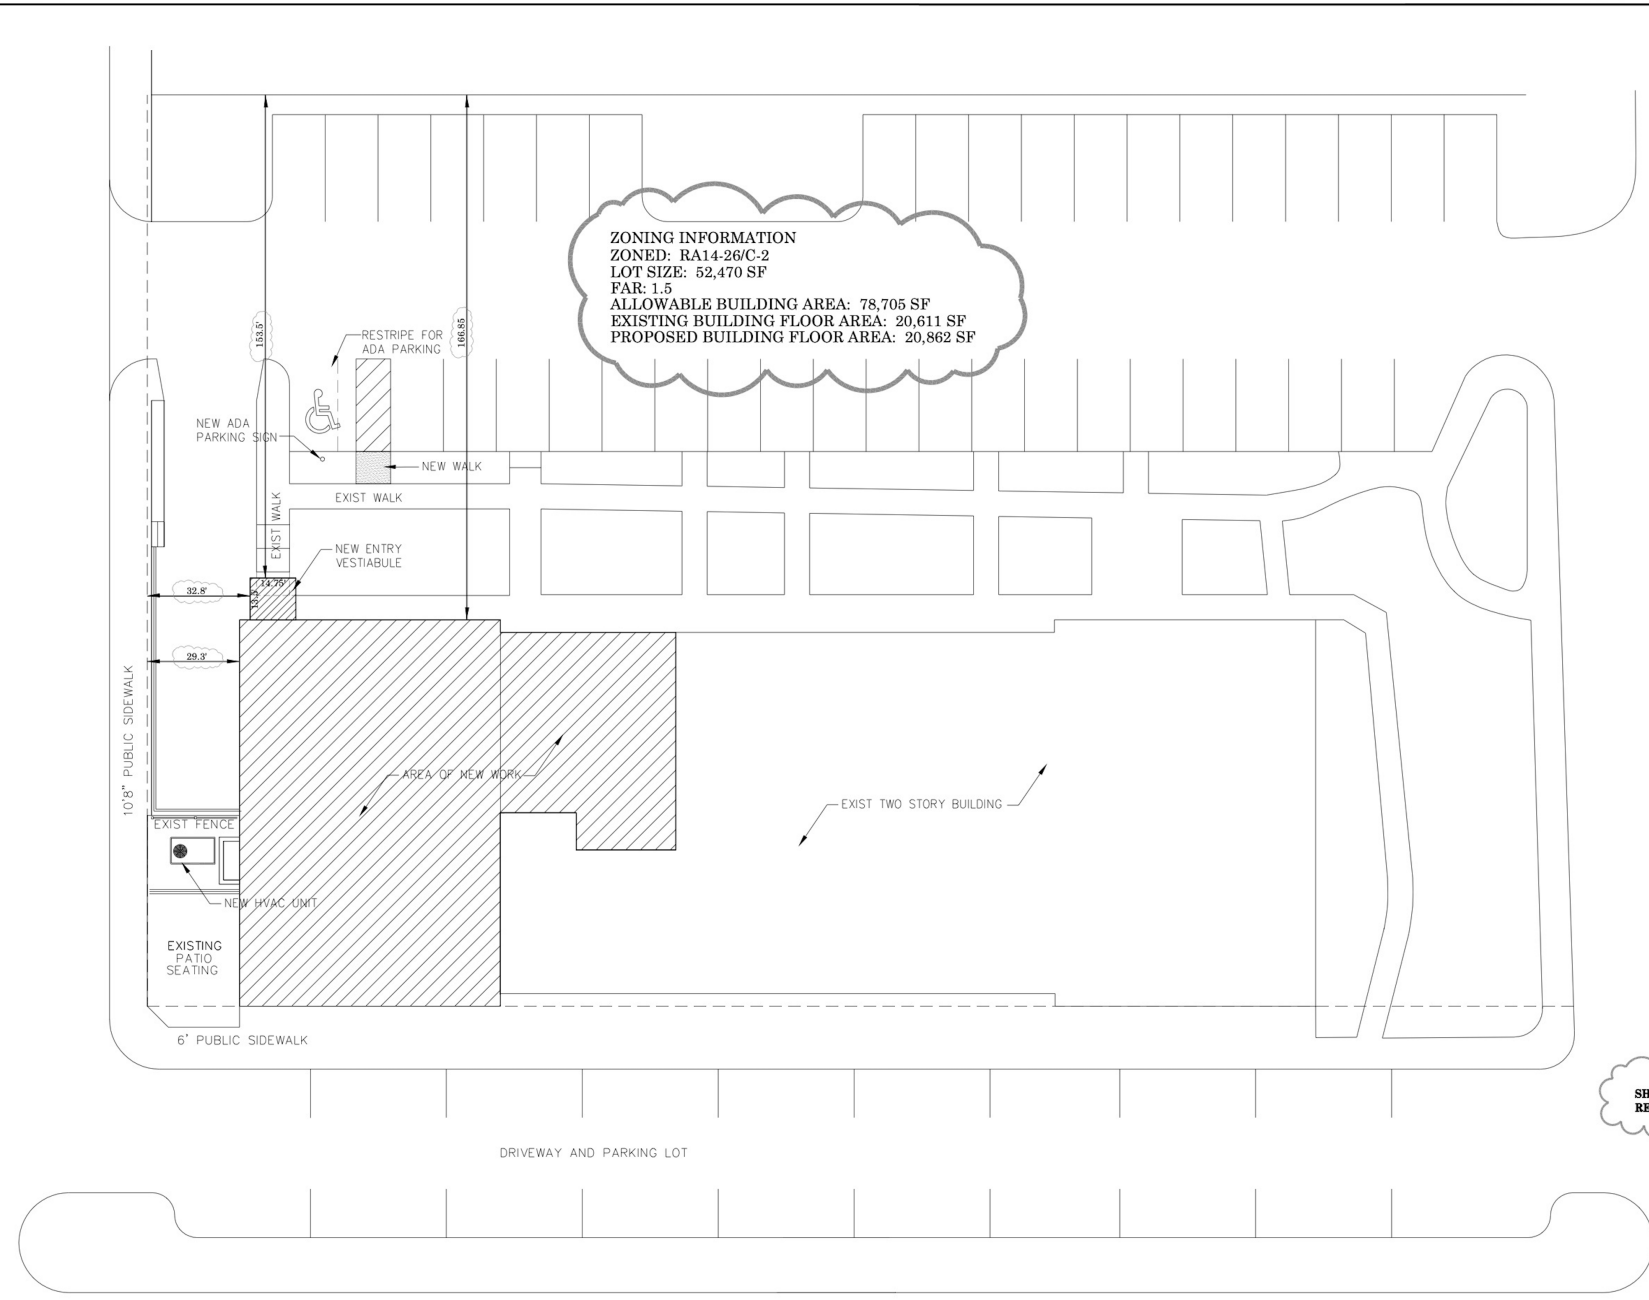

ZONING INFORMATION
 ZONED: RA14-26/C-2
 LOT SIZE: 52,470 SF
 FAR: 1.5
 ALLOWABLE BUILDING AREA: 78,705 SF
 EXISTING BUILDING FLOOR AREA: 20,611 SF
 PROPOSED BUILDING FLOOR AREA: 20,862 SF

SHEET REVISED FOR
 REVIEW COMMENTS

SITE PLAN



KJD ARCHITECTS, LLC
 4004 AURORA DRIVE, KENNINGTON, MARYLAND
 (301) 882-1811 KJDARCH@aol.com
 KEVIN J. DRESCOLL, A.A.

Irish Pub—Restaurant
 & Whiskey Bar
 2500 Columbia Pike
 Arlington, VA 22204
psyc house

PROJ. No.:
 2022-35
 REVISIONS:
 07-31-23

DRAWING:
 SITE / LOCATION PLAN

DATE:
 08-10-22
 SCALE:
 AS NOTED

A-0.1