


STREETLIGHT POLE AND FIXTURE SCHEDULE

POLE NUMBER	POLE TYPE, COLOR, HEIGHT	CCT
CLD3203N	16' DOUBLE CARLYLE, BLACK	3000K
CLD3204N	16' DOUBLE CARLYLE, BLACK	3000K



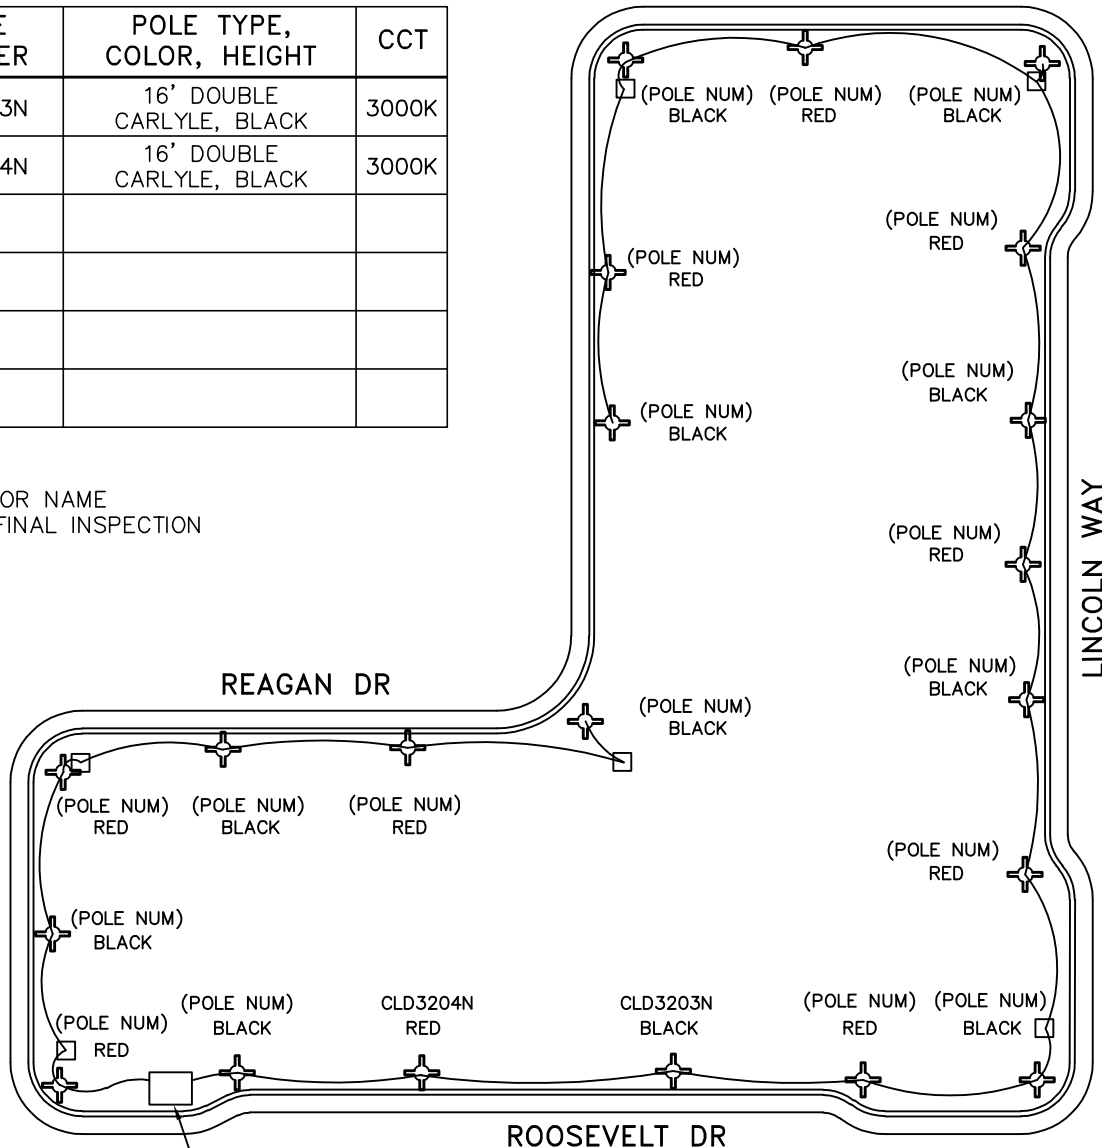


NIXON WAY

CONTRACTOR NAME
DATE OF FINAL INSPECTION



METER PEDESTAL
CIRCUIT BREAKER SIZE
WIRE SIZE
METER NUMBER

LEGEND

-  STREETLIGHT
-  POLE NUMBER
-  RED
-  CONDUIT RUN
-  JUNCTION BOX

SKELETON OUTLINE OF STREET LIGHT CIRCUITS SHOULD BE DEVOID OF ALL OTHER INFRASTRUCTURE AND SHOULD ONLY SHOW BASIC STREET GEOMETRY.

*NOT TO SCALE

AS-BUILT DRAWING (TYPICAL)

REVISION & DATE



ARLINGTON COUNTY, VIRGINIA
DEPARTMENT OF ENVIRONMENTAL SERVICES

DRAWING NO.
14130-01